


- 150mm coursed split faced stone to plinth
- 300mm coursed ashlar faced stone
- 300mm coursed ashlar stone recessed by 25mm
- Through colour white render
- Artificial slate to roof
- 100mm thk stone coping
- PPC Aluminium windows, colour anthracite grey
- PPC Aluminium head detail to windows with colour coordinate ventilation grills, colour anthracite grey
- I PPC Aluminium curtain walling, colour anthracite grey
- J Painted MS balustrade with toughened glass infill, paint colour anthracite grey
- K Painted MS channel section frame to projecting bay, paint colour anthracite grey

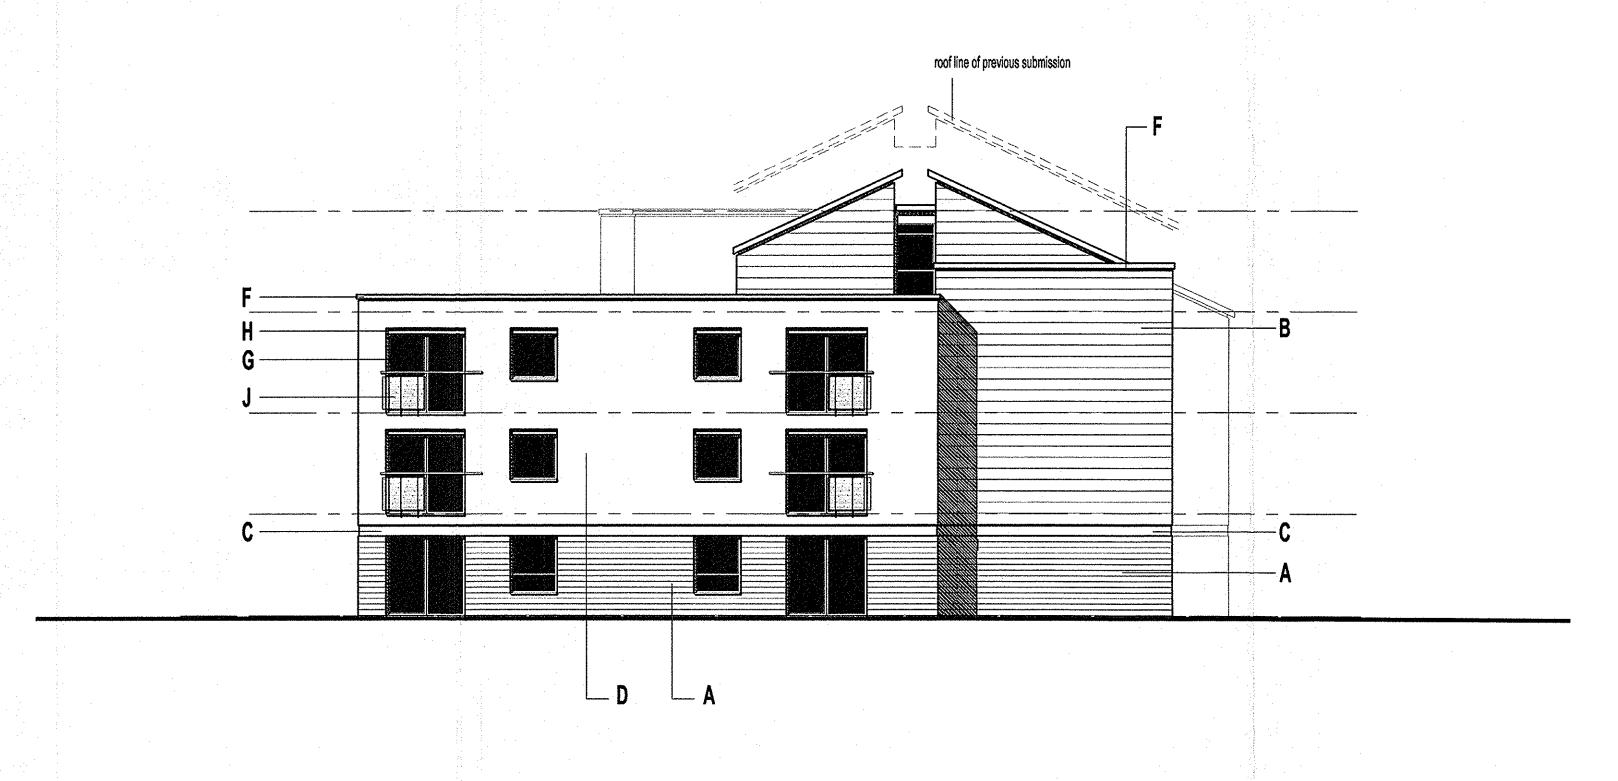

St Ann's Lane, Headingley

Contractor must verify all dimensions on site before commencing any work or shop

If this drawing exceeds the quantities taken in any way the Architects are to be informed before the work is initiated.

Only figured dimensions to be taken from this drawing. Do not scale off this drawing.

Drawings based on Ordnance Survey and/or existing record drawings - design and drawing content subject to Site Survey, Structural Survey, Site Investigations, Planning and Statutory Requirements and Approvals.

Authorised reproduction from Ordnance Survey Map with permission of the Controller of Her Majesty's Stationery Office. Crown Copyright reserved.

Carey Jones Architects Limited Copyright.

This drawing originates from the CAD file:

REVISIONS

Rev Desc A REVISED IN ACCORDANCE WITH LCC

24/412/051

LEEDS CITY COUNCIL Please refer to Decision Notice

- 3 AUG 2007



CAREYJONESARCHITECTS

Tel + 44 (0) 207 269 9400 Fax + 44 (0) 207 269 9401

E-mail info@careyjones.com

Project ST ANN'S LANE HEADINGLEY

APARTMENT ELEVATIONS SHEET 2 OF 2

Drawing No: 16,288 (20) 215